




insight
design

1900 N. Bayshore
Drive - #204-A
Miami, Florida
3 3 1 3 2
305.545.4964

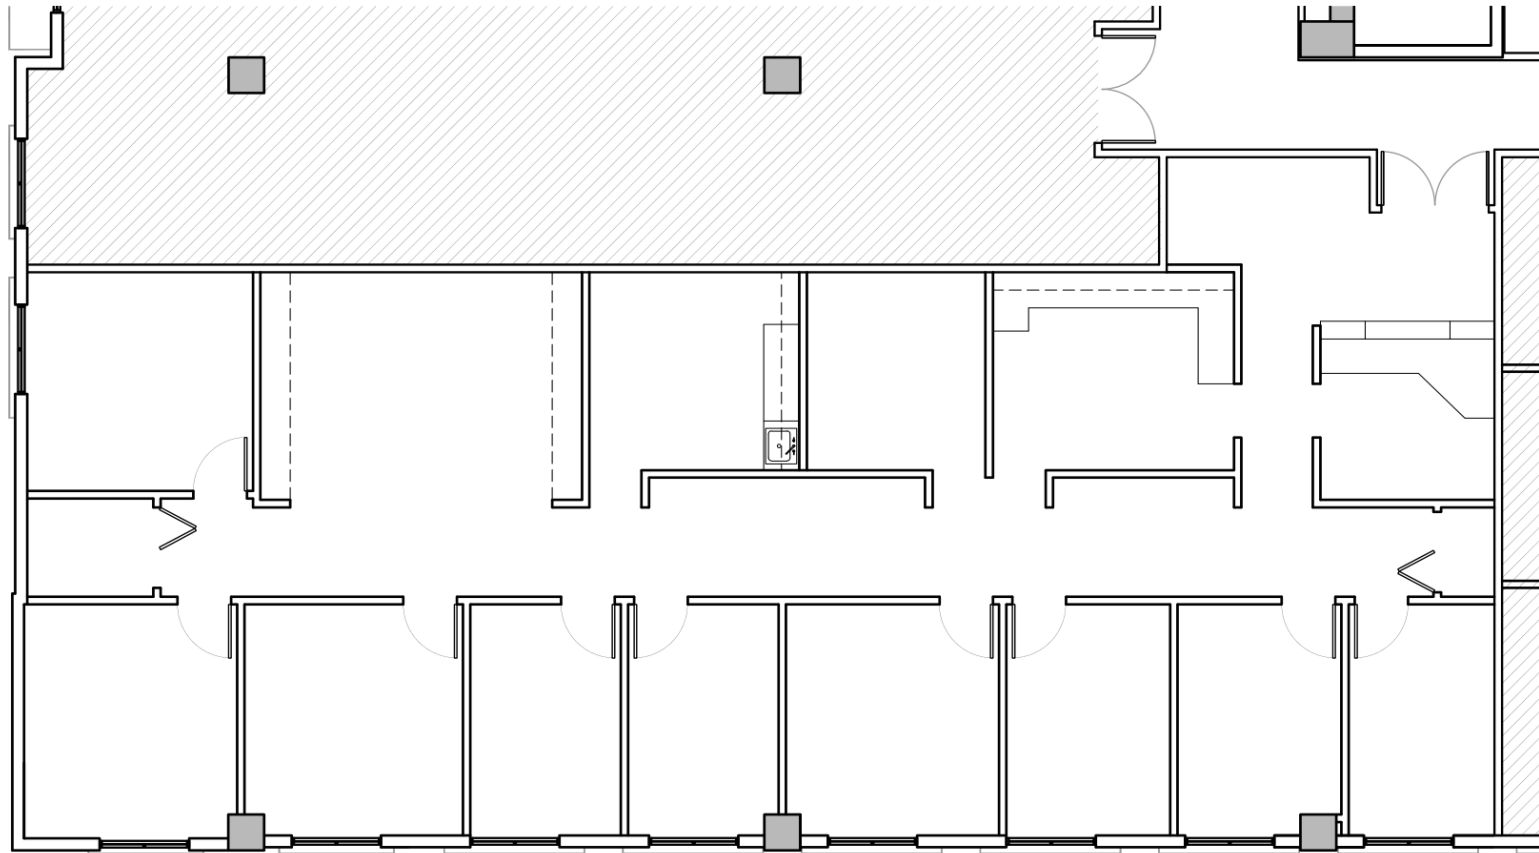

4000 Ponce de Leon

As Built - Suite 410

3/32"=1'-0"



LEASING SERVICES

PROJECT NO:	1806-00
DRAWN BY:	I.G.
DATE:	05/07/2020
SCALE:	AS NOTED
SHEET NO:	SK-1