



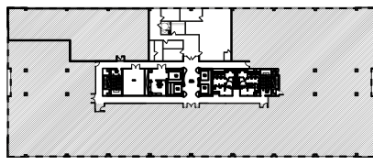

insight
design

2930 Northeast
2nd Court
Miami, Florida
33137
305.545.4964

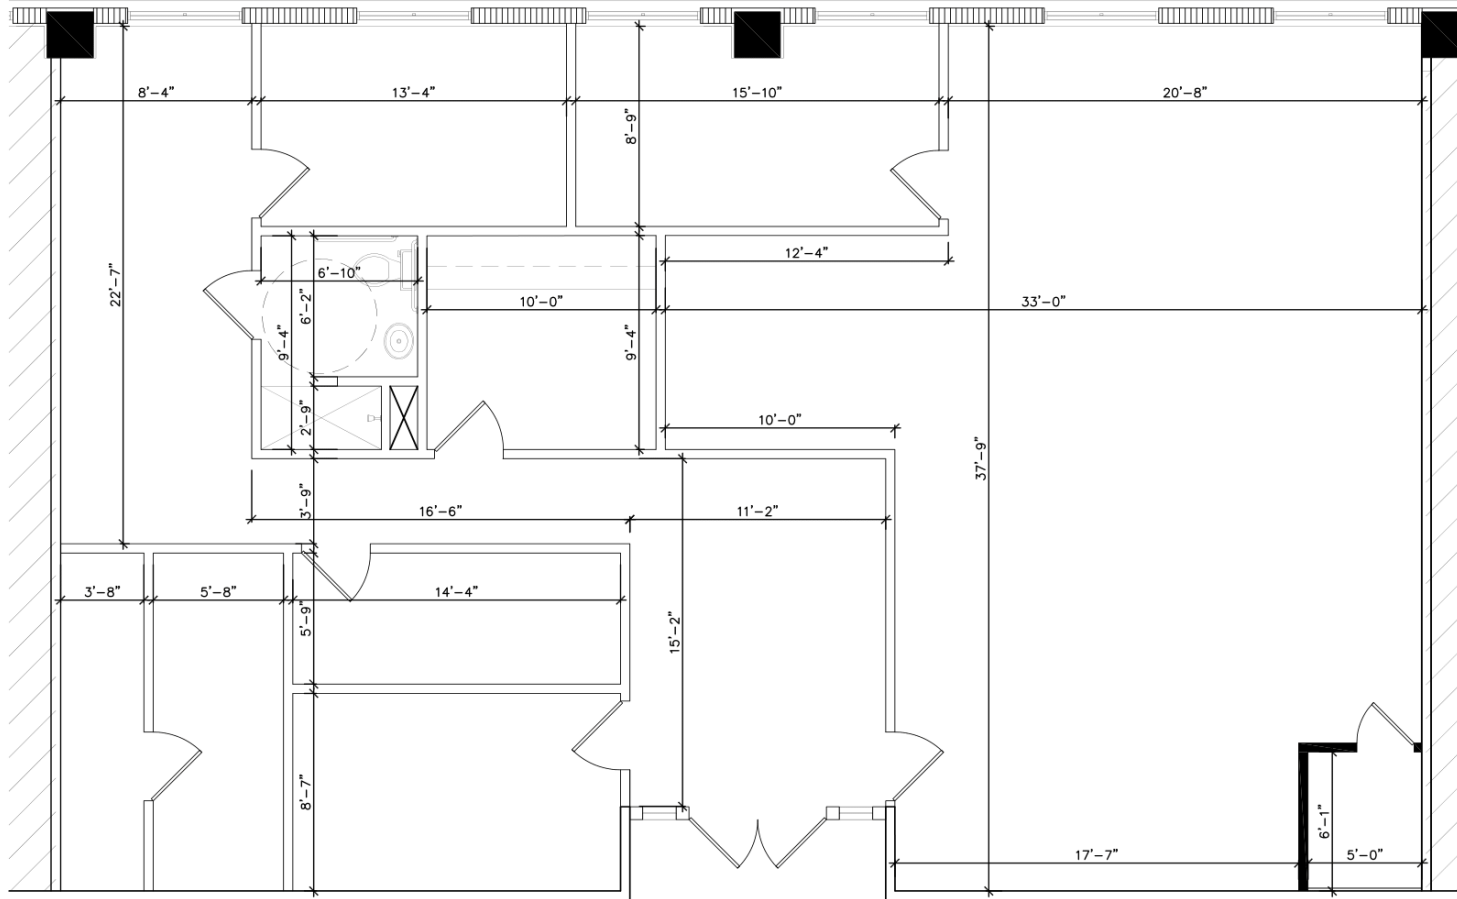

Key Plan



4000 Ponce de Leon

SUITE 750 | Remainder As-Built Area 2,678.29 R.S.F.

7TH-FLOOR

1/8"=1'-0"



PROJECT NO:	1806-00
DRAWN BY:	I.M.
DATE:	04/12/19
SCALE:	As-Noted
SHEET NO:	SK-1