




insight  
design

1900 N. Bayshore  
Drive - #204-A  
Miami, Florida  
3 3 1 3 7  
305.545.4964

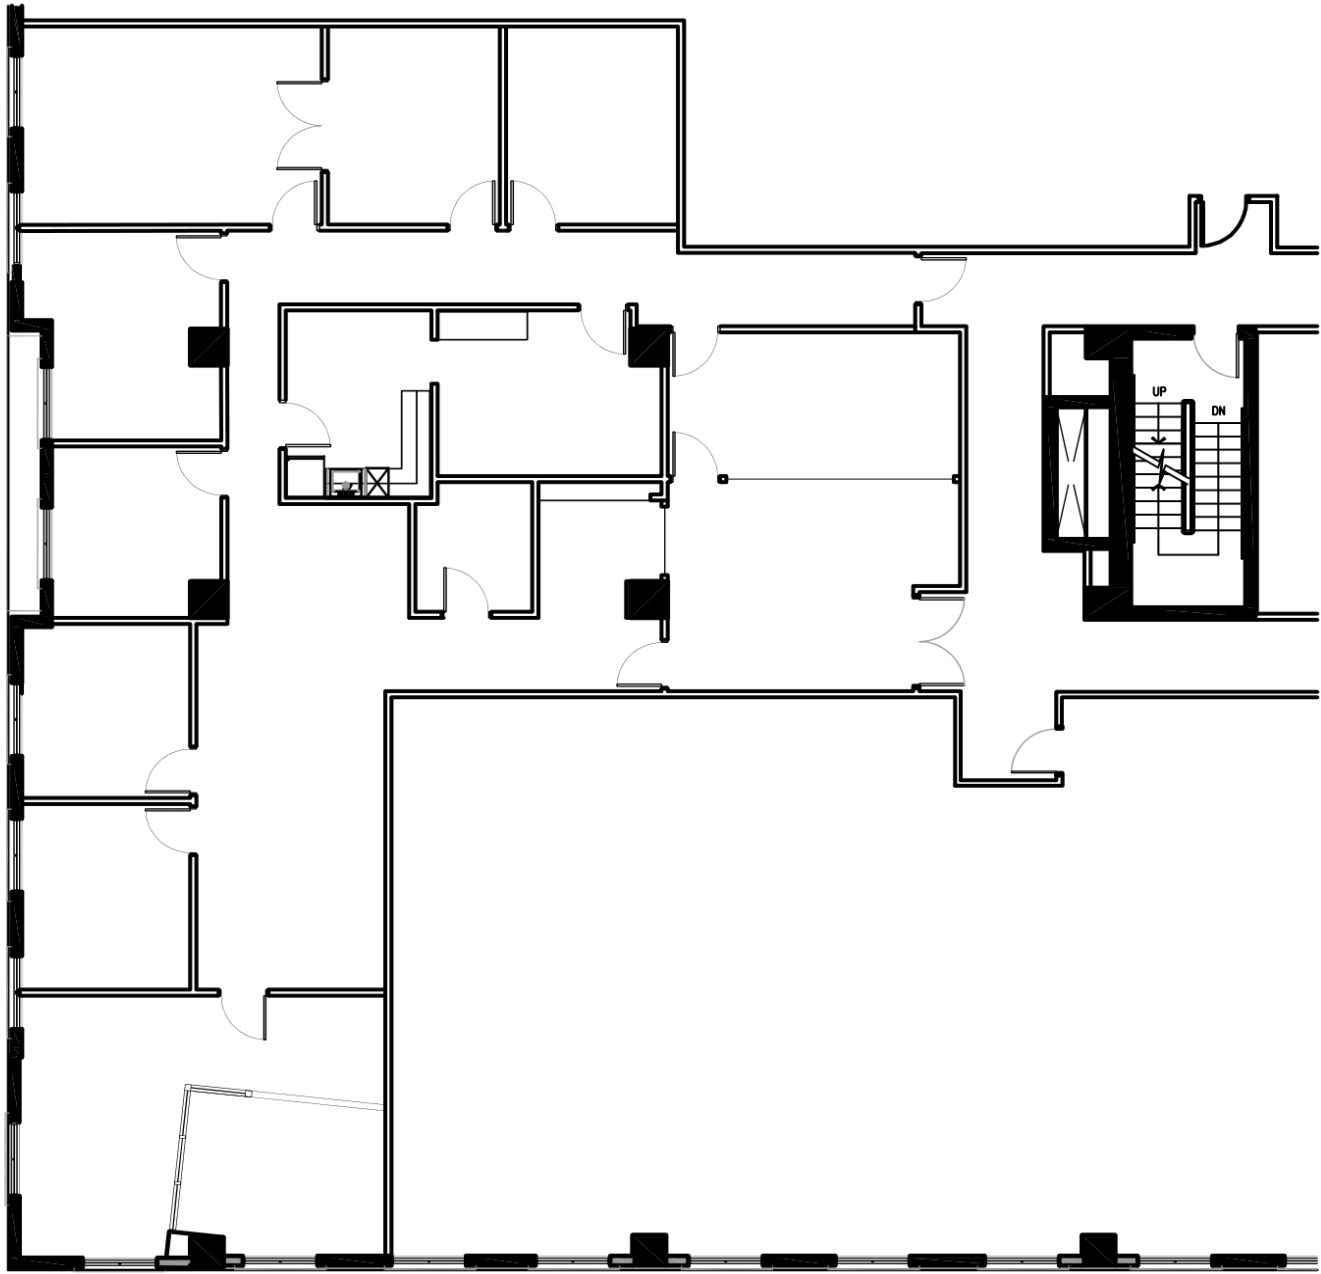

**4000 Ponce de Leon**  
Suite 770 / As Built

7TH-FLOOR  
N.T.S.



|             |          |
|-------------|----------|
| PROJECT NO: | 1806-00  |
| DRAWN BY:   | I.M.     |
| DATE:       | 07/17/20 |
| SCALE:      | N.T.S.   |
| SHEET NO:   | SK-1     |