




insight
design
2930 Northeast
2nd Court
Miami, Florida
33137
305.545.4964

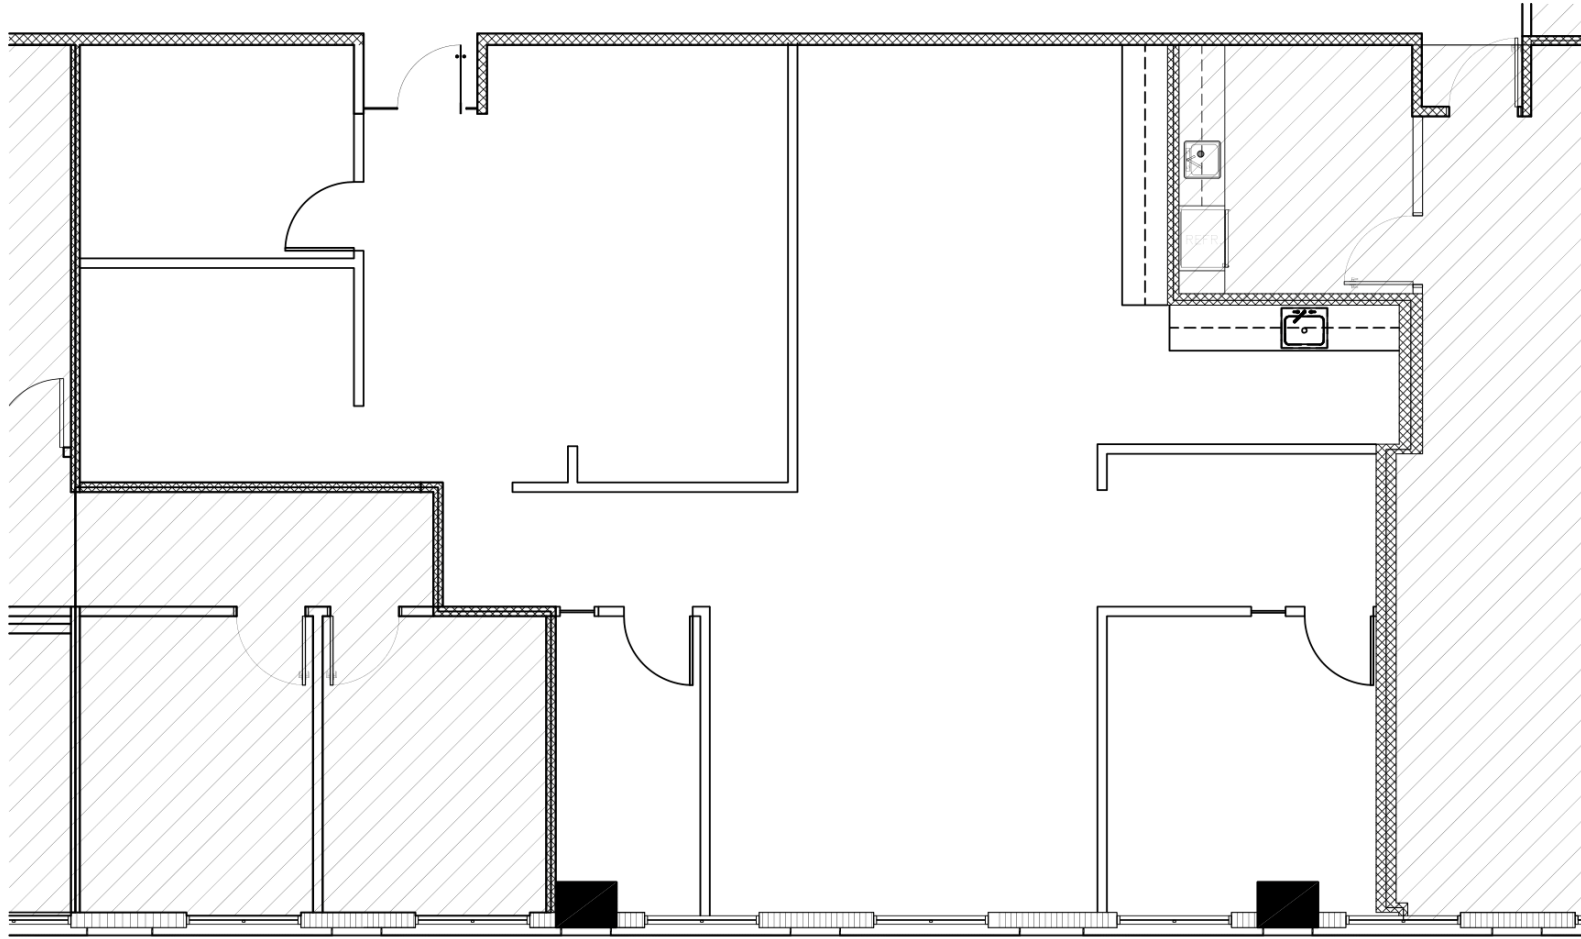

4000 Ponce de Leon
As-Built Plan / Suite 430

4TH-FLOOR



PROJECT NO:	1806-00
DRAWN BY:	I.M.
DATE:	06/27/19
SCALE:	1/8"=1'-0"
SHEET NO:	SK-1